


FLOOR 30

SUITE 3000 / 8,375 SF


IN LEASES

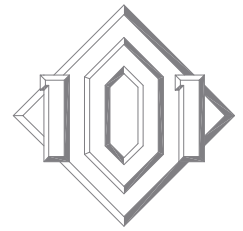

101 CALIFORNIA

AS BUILT PLAN-

- Pre-built suite.
- Double door elevator identity.
- 13 perimeter offices with glass fronts, 1 large interior conference room with glass front, 1 small interior conference room with glass front, large kitchen with sink, dishwasher and upper and lower cabinets, large production room, telecom closet, and reception area.
- Exceptional views of the Golden Gate Bridge, Russian Hill, Marin Headlands, and San Francisco Bay.
- Can be combined with adjacent suite for a contiguous 15,463 sq. ft.

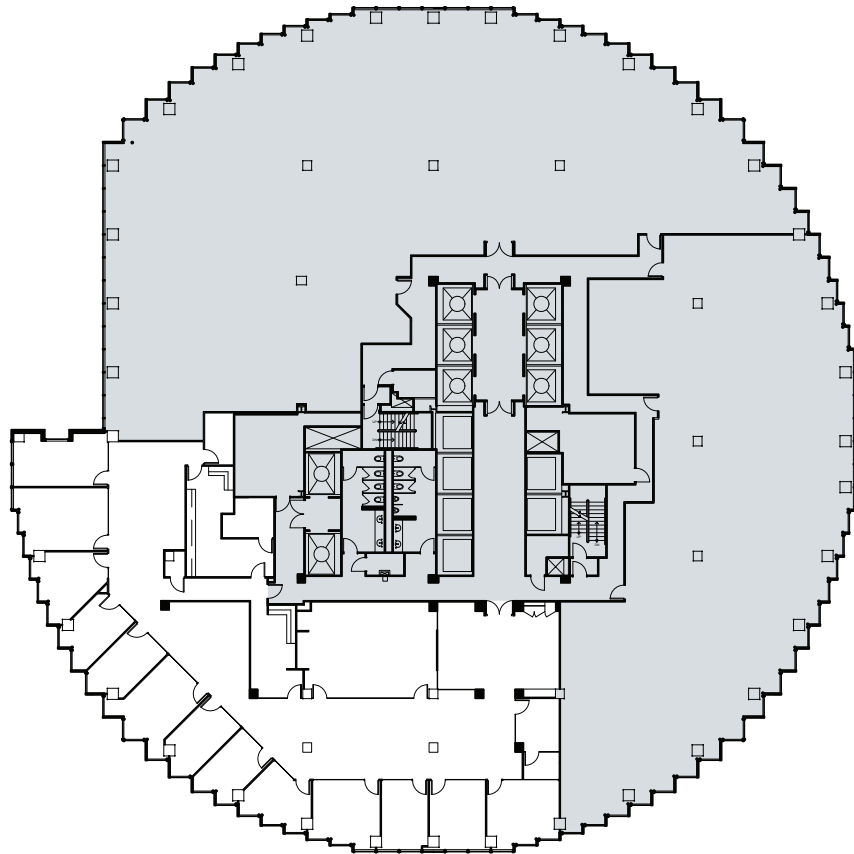

FOR LEASING INFORMATION, CONTACT:

JOHN CECCONI

Executive Vice President
Lic. 00676355
+1 415 291 8883
john.cecconi@cbre.com

KEN CHURICH

Senior Vice President
Lic. 00887925
+1 415 291 1728
ken.churich@cbre.com

SAM STEIN

Associate
Lic. 02026162
+1 415 772 0209
sam.stein@cbre.com

Hines **CBRE**

© 2018 CBRE, Inc. All rights reserved. This information has been obtained from sources believed reliable, but has not been verified for accuracy or completeness. You should conduct a careful, independent investigation of the property and verify all information. Any reliance on this information is solely at your own risk. CBRE and the CBRE logo are service marks of CBRE, Inc. All other marks displayed on this document are the property of their respective owners. Photos herein are the property of their respective owners and use of these images without the express written consent of the owner is prohibited. PMStudio_October 2018