



10/FL
2,966 sf

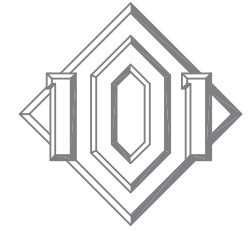

101 CALIFORNIA

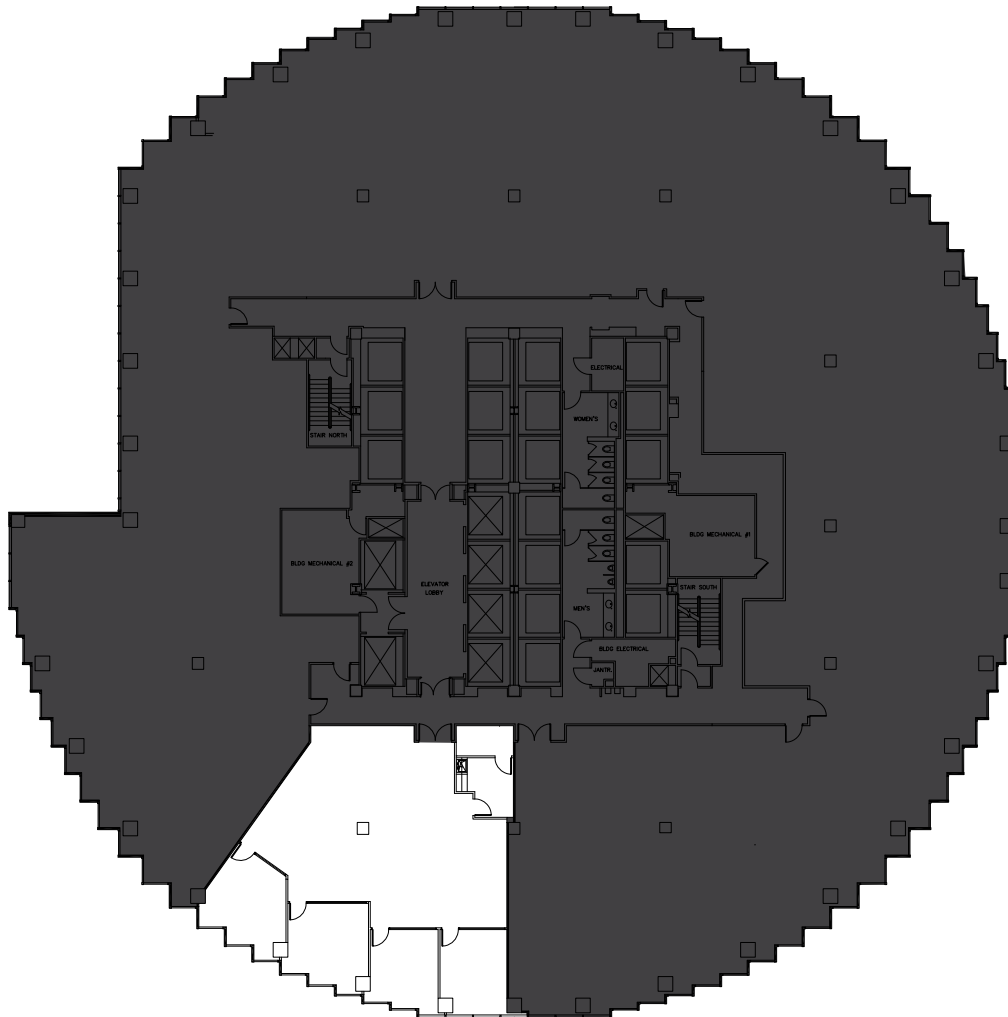

As Built Plan

- Highly improved pre-built suite
- 3 perimeter offices with glass fronts, 1 perimeter conference room with glass front, kitchen with sink and upper and lower cabinets, reception area and telecom closet
- Exceptional San Francisco cityscape views
- Available December 20, 2018

Contact

Matt Kruvant
matt.kruvant@hines.com
101 California Street, Suite 1000
San Francisco, CA 94111
415.982.6200
www.101california.com



Hines