



30/FL
7,088 sf

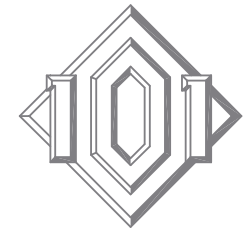

101 CALIFORNIA

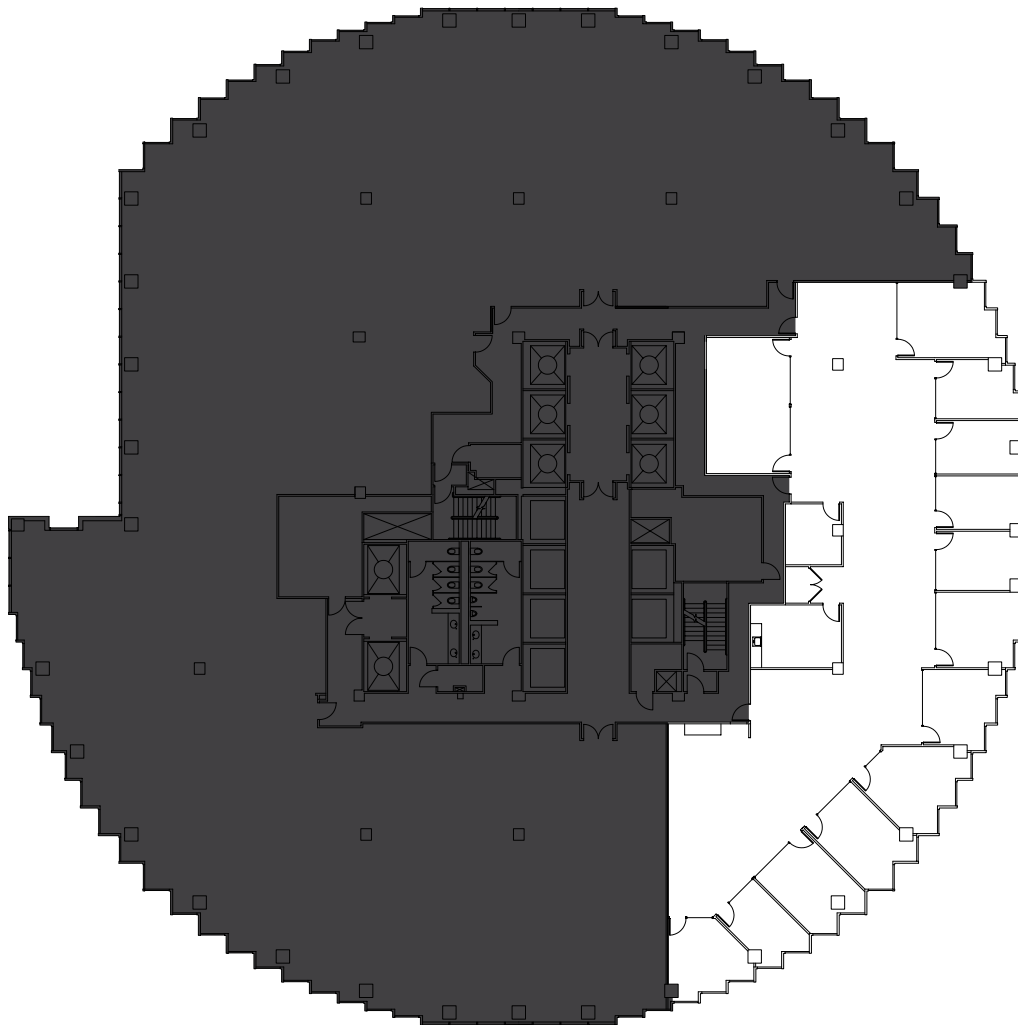

As Built Plan

- Highly improved pre-built suite
- 11 perimeter offices with glass fronts, 1 perimeter conference room with glass front, 1 large interior conference room with glass front, kitchen with sink and upper and lower cabinets, production room, telecom closet, and reception area
- Exceptional panoramic views of the Bay Bridge and San Francisco Cityscape
- Can be combined with adjacent suite for a contiguous 15,463 sq. ft.
- Available immediately

Contact

Matt Kruvant
matt.kruvant@hines.com
101 California Street, Suite 1000
San Francisco, CA 94111
415.982.6200
www.101california.com



Hines