



30/FL  
8,375sf

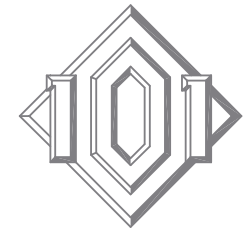

101 CALIFORNIA

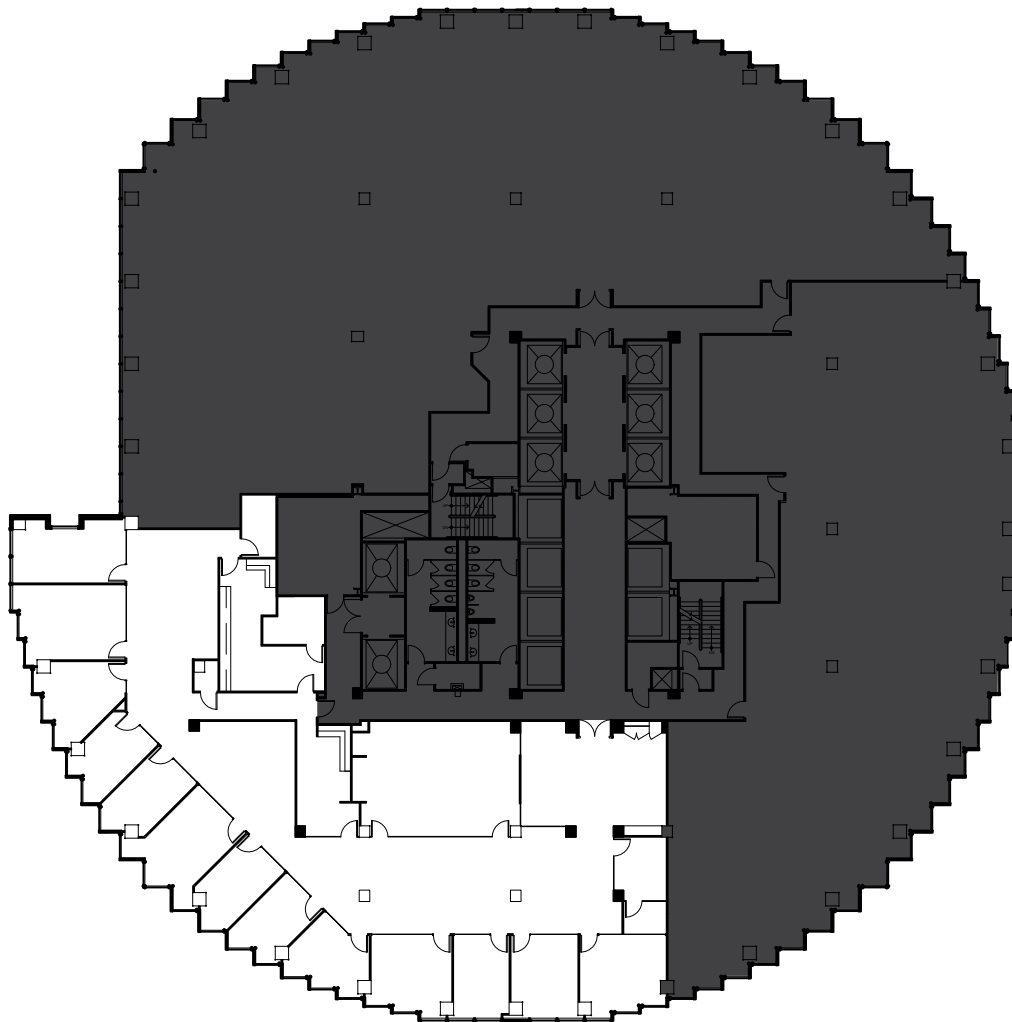

#### As Built Plan

- Pre-built suite
- Double door elevator identity
- 13 perimeter offices with glass fronts, 1 large interior conference room with glass front, 1 small interior conference room with glass front, large kitchen with sink, dishwasher and upper and lower cabinets, large production room, telecom closet, and reception area
- Exceptional views of the Golden Gate Bridge, Russian Hill, Marin Headlands, and San Francisco Bay
- Can be combined with adjacent suite for a contiguous 15,463 sq. ft.
- Available January 1, 2019

#### Contact

Matt Kruvant  
matt.kruvant@hines.com  
101 California Street, Suite 1000  
San Francisco, CA 94111  
415.982.6200  
www.101california.com



**Hines**