



39/FL  
25,633 sf

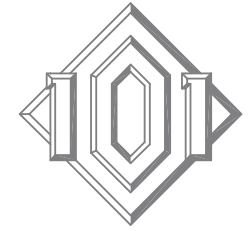

101 CALIFORNIA

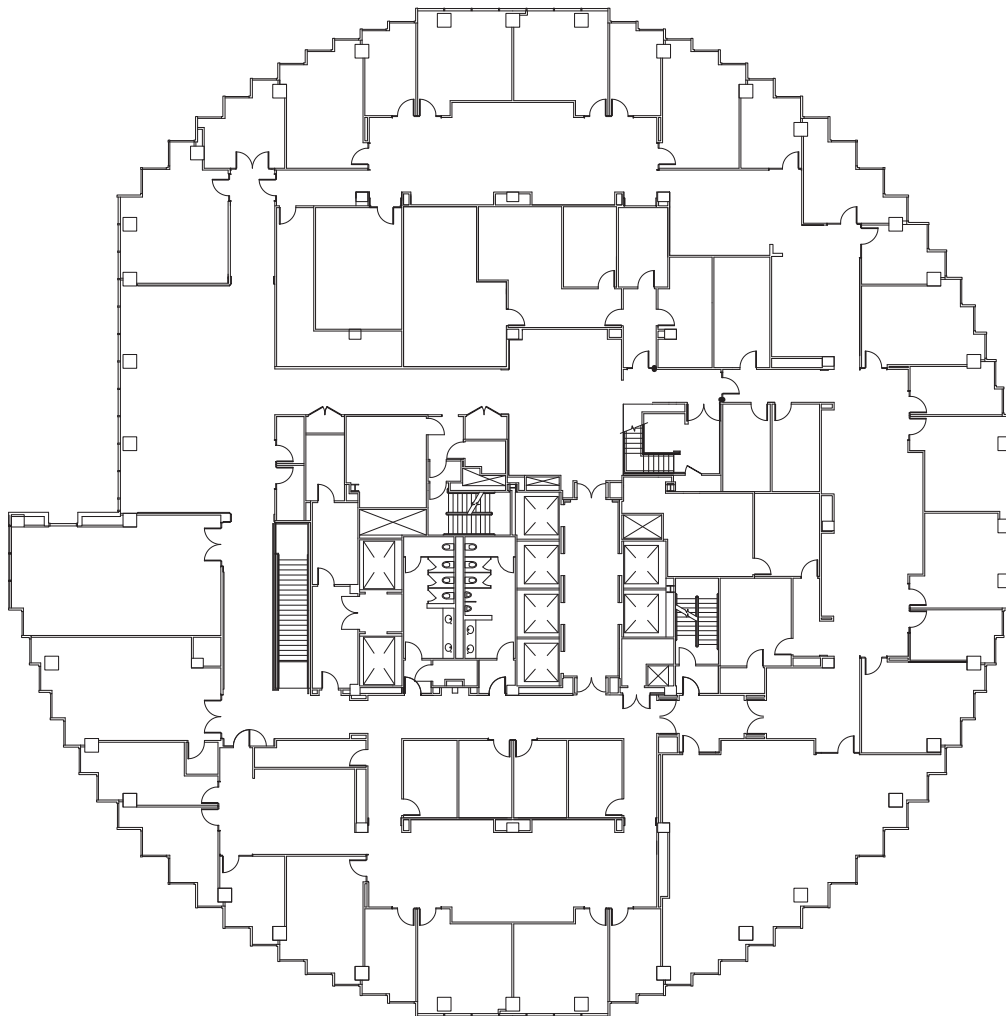

#### As Built Plan

- Pre-built high-end law firm space
- 31 private offices and 7 conference rooms
- Part of a 76,036 contiguous sf block
- Exceptional panoramic views of the Golden Gate Bridge, Bay Bridge, Mt. Tam, Alcatraz and Pacific Ocean
- Available immediately

#### Contact

David Eaton  
david.eaton@hines.com  
Matt Kruvant  
matt.kruvant@hines.com  
101 California Street, Suite 1000  
San Francisco, CA 94111  
415.982.6200  
www.101california.com



**Hines**