



39/FL
4,095 sf

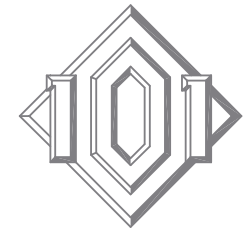

101 CALIFORNIA

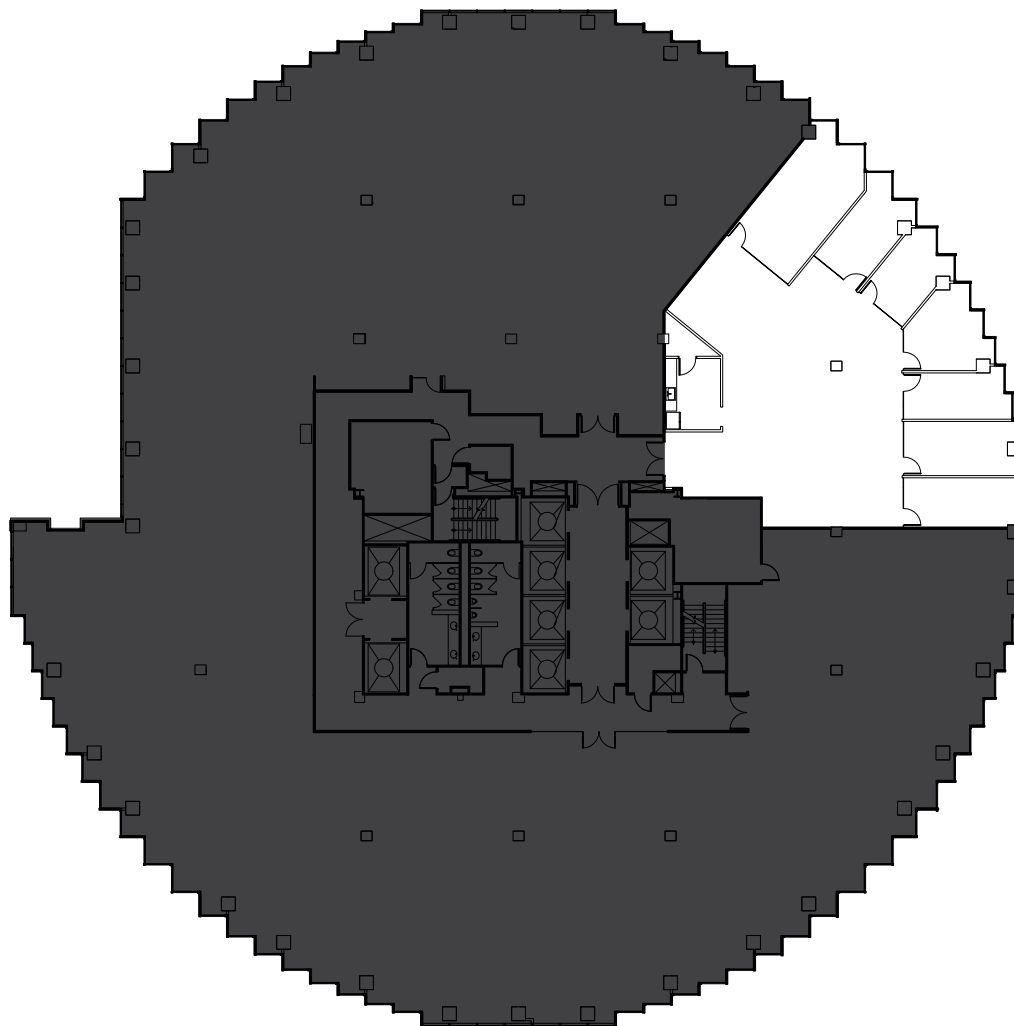

As Built Plan

- One of two new, contiguous pre-built suites
- 6 perimeter offices with full-height glass fronts, 1 perimeter conference room with full-height glass front, kitchen/production area, IT closet, substantial open area for up to 22 desks
- Double door identity
- Exceptional views of Bay Bridge, Treasure Island, Berkley Hills, Mt. Diablo and San Francisco Bay
- Available immediately

Contact

David Eaton
david.eaton@hines.com
Matt Kruvant
matt.kruvant@hines.com
101 California Street, Suite 1000
San Francisco, CA 94111
415.982.6200
www.101california.com



Hines