
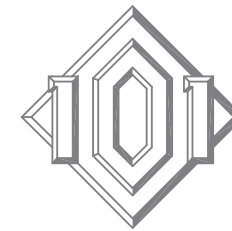


39/FL
4,165 sf

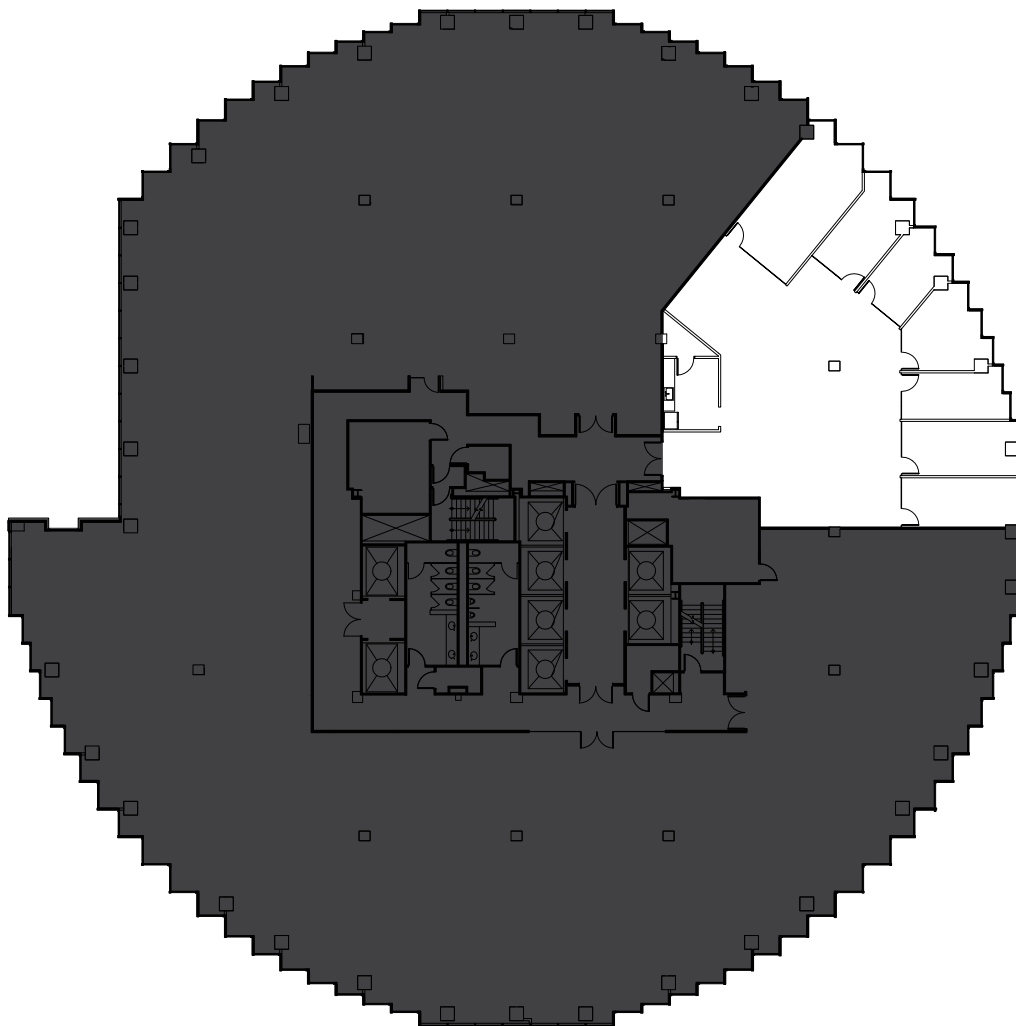

101 CALIFORNIA

As Built Plan

- One of three new, contiguous pre-built suites
- 6 perimeter offices with full-height glass fronts, 1 perimeter conference room with full-height glass front, kitchen/production area, IT closet, substantial open area
- Double door identity
- Exceptional views of Bay Bridge, Treasure Island, Berkley Hills, Mt. Diablo and San Francisco Bay
- Available November 1st

Contact

David Eaton
david.eaton@hines.com
Matt Kruvant
matt.kruvant@hines.com
101 California Street, Suite 1000
San Francisco, CA 94111
415.982.6200
www.101california.com



Hines