



39/FL
4,460 sf

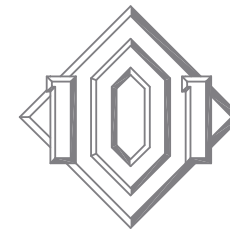

101 CALIFORNIA

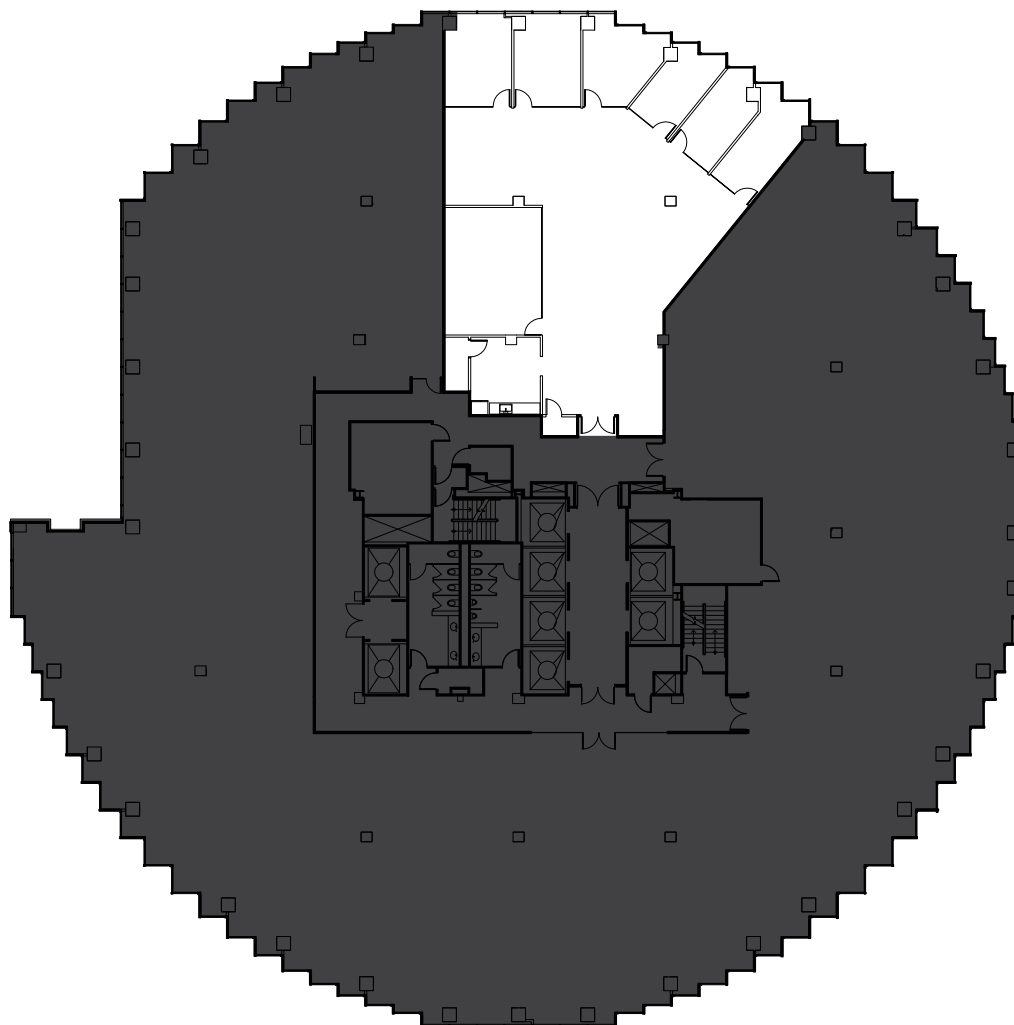

As Built Plan

- One of three new, contiguous pre-built suites
- 6 perimeter offices with full-height glass fronts, 1 interior conference room with full-height glass front, kitchen/production area, IT closet, open area
- Double door elevator identity
- Exceptional views of Bay Bridge, Treasure Island, Coit Tower, Mt. Diablo and San Francisco Bay
- Available November 1st

Contact

David Eaton
david.eaton@hines.com
Matt Kruvant
matt.kruvant@hines.com
101 California Street, Suite 1000
San Francisco, CA 94111
415.982.6200
www.101california.com

Hines