



39/FL
4,530sf

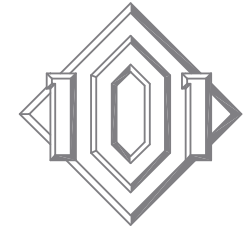

101 CALIFORNIA

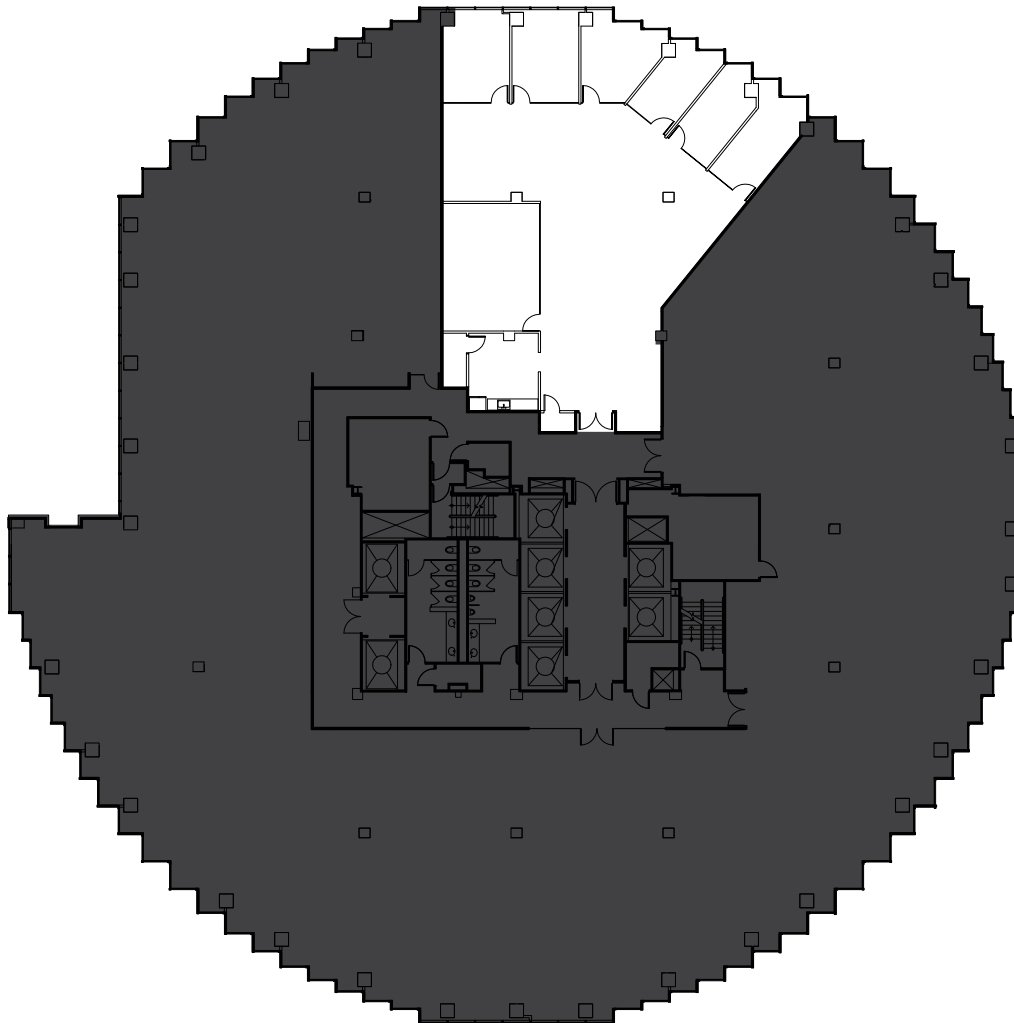

As Built Plan

- 6 perimeter offices with full-height glass fronts, 1 interior conference room with full-height glass front, kitchen/production area, IT closet, open area for up to 20 desks
- Double door elevator identity
- Exceptional views of Bay Bridge, Treasure Island, Coit Tower, Mt. Diablo and San Francisco Bay
- Available immediately

Contact

David Eaton
david.eaton@hines.com
Matt Kruvant
matt.kruvant@hines.com
101 California Street, Suite 1000
San Francisco, CA 94111
415.982.6200
www.101california.com



Hines