



40/FL
25,633 sf

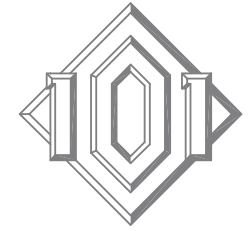

101 CALIFORNIA

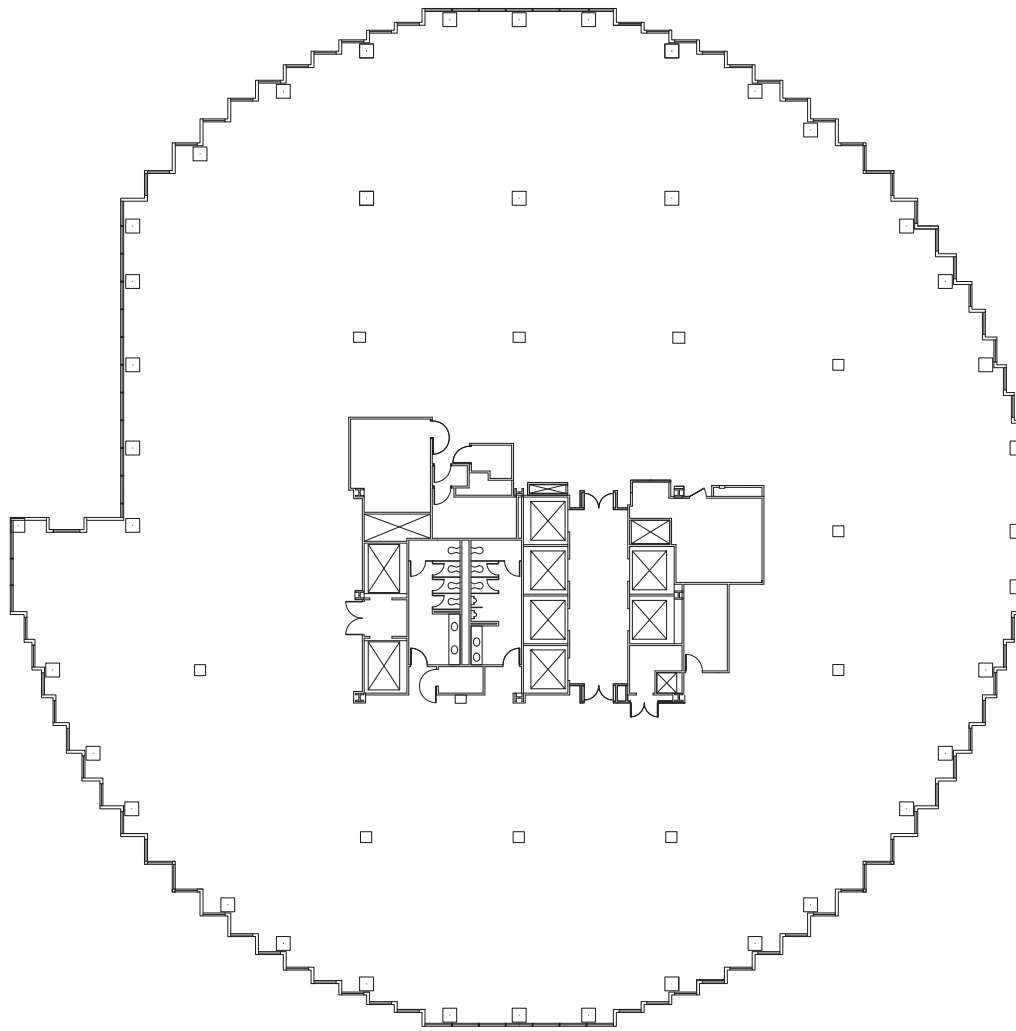

As Built Plan

- Full Floor opportunity
- Part of a 76,036 contiguous sf block
- Exceptional panoramic views of the Golden Gate Bridge, Bay Bridge, Mt. Tam, Alcatraz and Pacific Ocean
- Available immediately

Contact

David Eaton
david.eaton@hines.com
Matt Kruvant
matt.kruvant@hines.com
101 California Street, Suite 1000
San Francisco, CA 94111
415.982.6200
www.101california.com

Hines