
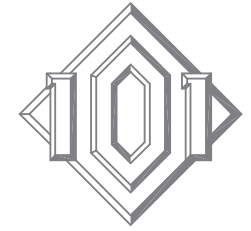


42/FL
5,475 sf

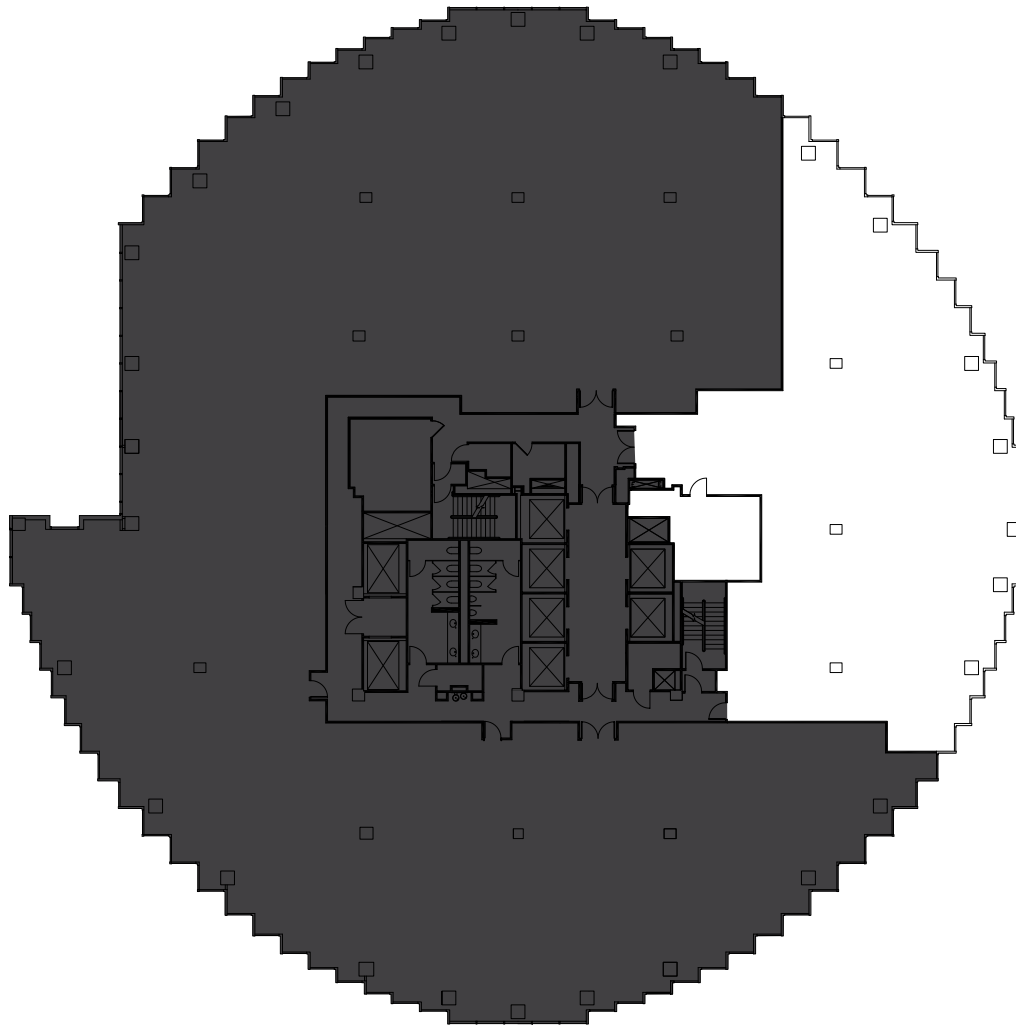

101 CALIFORNIA

As Built Plan

- Pre-built suite
- A mixture of conference rooms and perimeter offices with over-standard finishes
- Sweeping views of the Bay Bridge, bay, and south financial cityscape
- Available April 1, 2018

Contact

David Eaton
david.eaton@hines.com
Matt Kruvant
matt.kruvant@hines.com
101 California Street, Suite 1000
San Francisco, CA 94111
415.982.6200
www.101california.com



Hines