



45/FL
6,863 sf

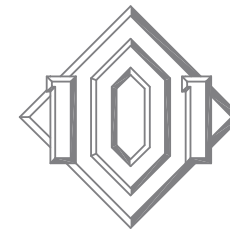

101 CALIFORNIA

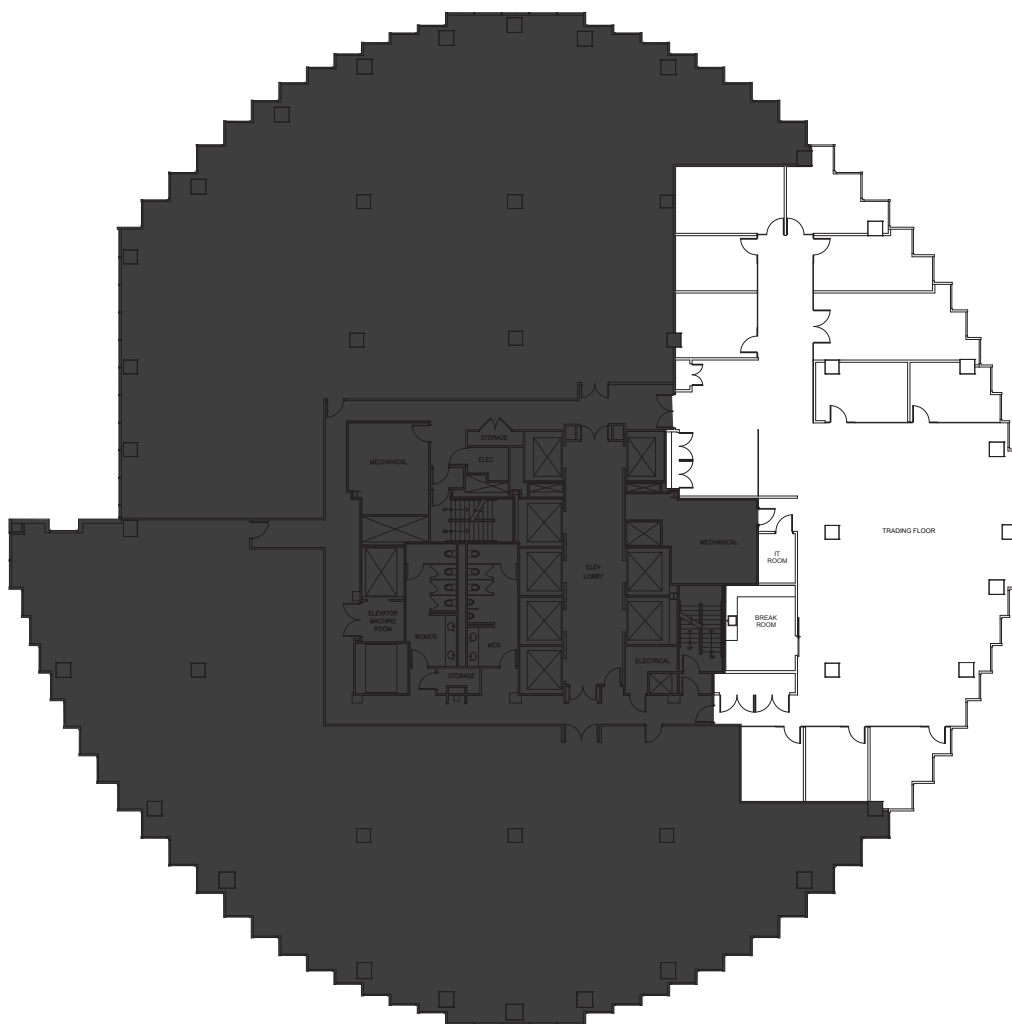

As Built Plan

- High-end pre-built financial services suite with large open area for trading
- Recent build-out with modern finishes
- 4 perimeter private offices with glass fronts, 5 internal private offices with glass fronts, 1 larger perimeter conference room with glass front, 1 internal conference room with glass front, large kitchen / break room, substantial open area
- Double-door entry
- Sweeping views of the San Francisco Bay, Bay Bridge, Oakland, Berkeley, and Mt. Diablo
- Available immediately

Contact

David Eaton
david.eaton@hines.com
Matt Kruvant
matt.kruvant@hines.com
101 California Street, Suite 1000
San Francisco, CA 94111
415.982.6200
www.101california.com



Hines