15/FL
3,004 sf

101 CALIFORNIA

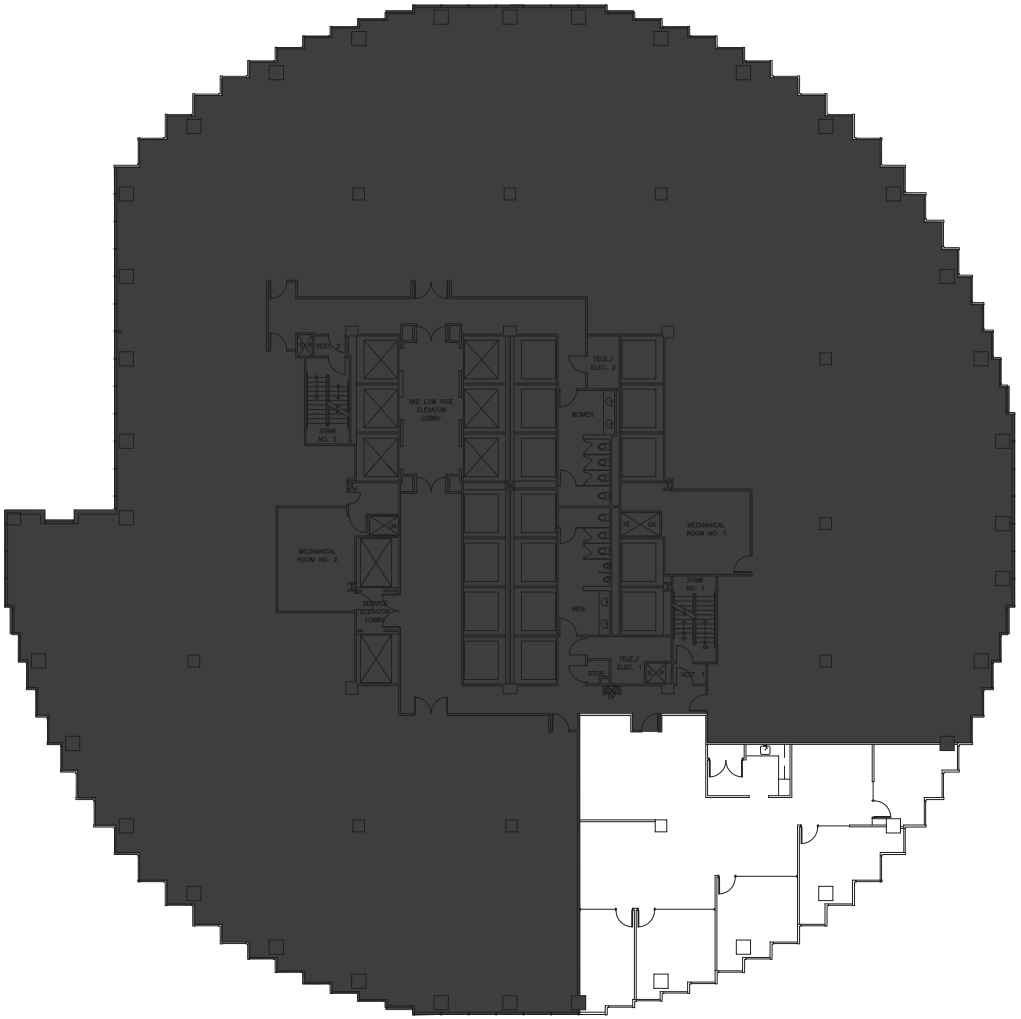

As Built Plan

- Pre-built suite
- 5 perimeter offices with full-height glass fronts, 1 interior conference area, kitchen / production area, telecom closet, formal reception area
- Available immediately

Contact

David Eaton
david.eaton@hines.com
Matt Kruvant
matt.kruvant@hines.com
101 California Street, Suite 1000
San Francisco, CA 94111
415.982.6200
www.101california.com

Hines